


1 GENERAL ARRANGEMENT PLAN
SCALE - 1:50

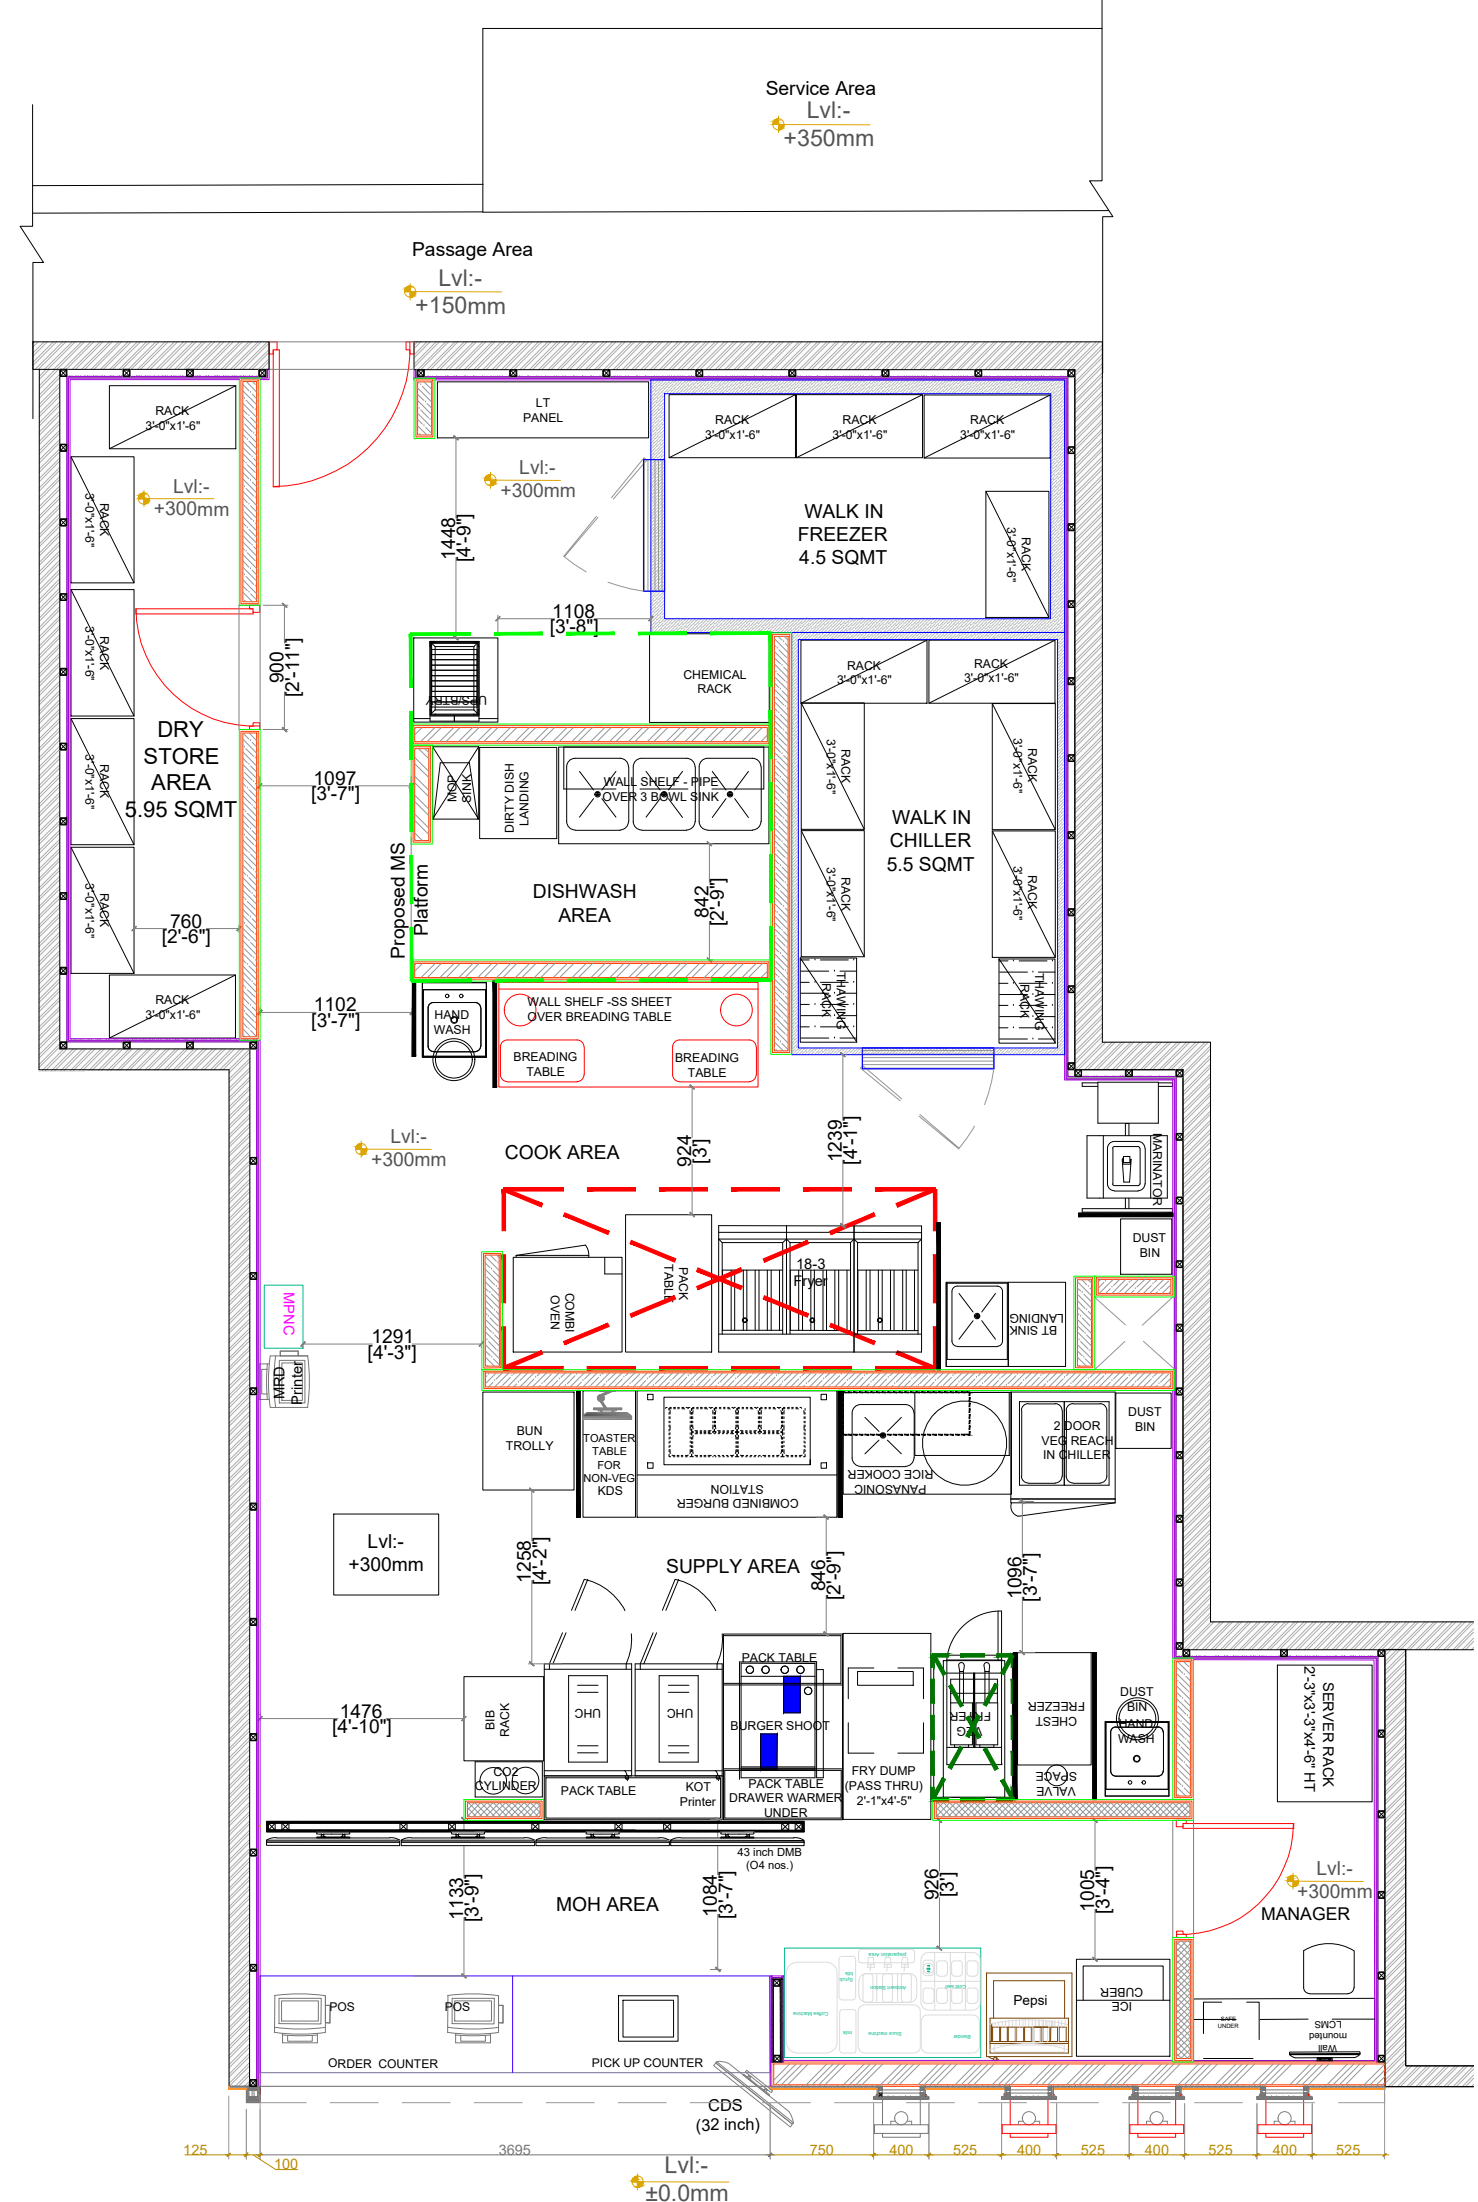

SCHEDULE OF AREAS	
Total Area (m ²)	94.0 m ²
BOH Area (m ²)	88.0 m ²
Walk in Chillar (m ²)	4.0 m ²
Walk in Freezer (m ²)	5.7 m ²
Dry Store (m ²)	5.95 m ²
Manager Room (m ²)	4.78 m ²
BOH Usable Area (m ²)	67.57 m ²

PROJECT
KFC
MUMBAI T1C

NOTE:
THIS DRAWING & DESIGN IS THE COPYRIGHT OF THE DESIGNER. NO PORTION MAY BE REPRODUCED WITHOUT THE WRITTEN PERMISSION OF THE DESIGNERS

- ALL DIMENSIONS ARE INCLUDING FINISHES
- DO NOT SCALE DRAWING. ONLY MENTIONED DIMENSIONS ARE TO BE CONSIDERED.
- ALL DIMENSIONS MUST BE CHECKED BEFORE COMMENCING WORK ON SITE.
- ANY DISCREPANCIES SHALL BE BROUGHT UNDER THE NOTICE OF ARCHITECTS PRIOR COMMENCEMENT OF WORK.

RELEASED FOR:

information	tender	construction	as built

REVISION

S.NO.	REMARKS	DATE
-	-	-
-	-	-
TITLE
GENERAL ARRANGEMENT PLAN

DATE	12 02 2024
SCALE	1:60
DRAWN BY	MAMTA
CHD BY	ANKIT P
DWG. NO.	A-101

CONSULTANT

CONSULTANT

ARCHITECT/ INTERIOR DESIGN
Genesis Architects Pvt. Ltd.
380, Second Floor, Rangpuri, Near Shiv Murti, NH-8, New Delhi-110037
Tel/fax: 011 25062077-79
E-mail: genarchpl@gmail.com