


Please show different between existing and new elements


is the wall being build off the demise line?  
Please confirm the finishing of this wall.  
Also are there plans to add any ceiling in this area?

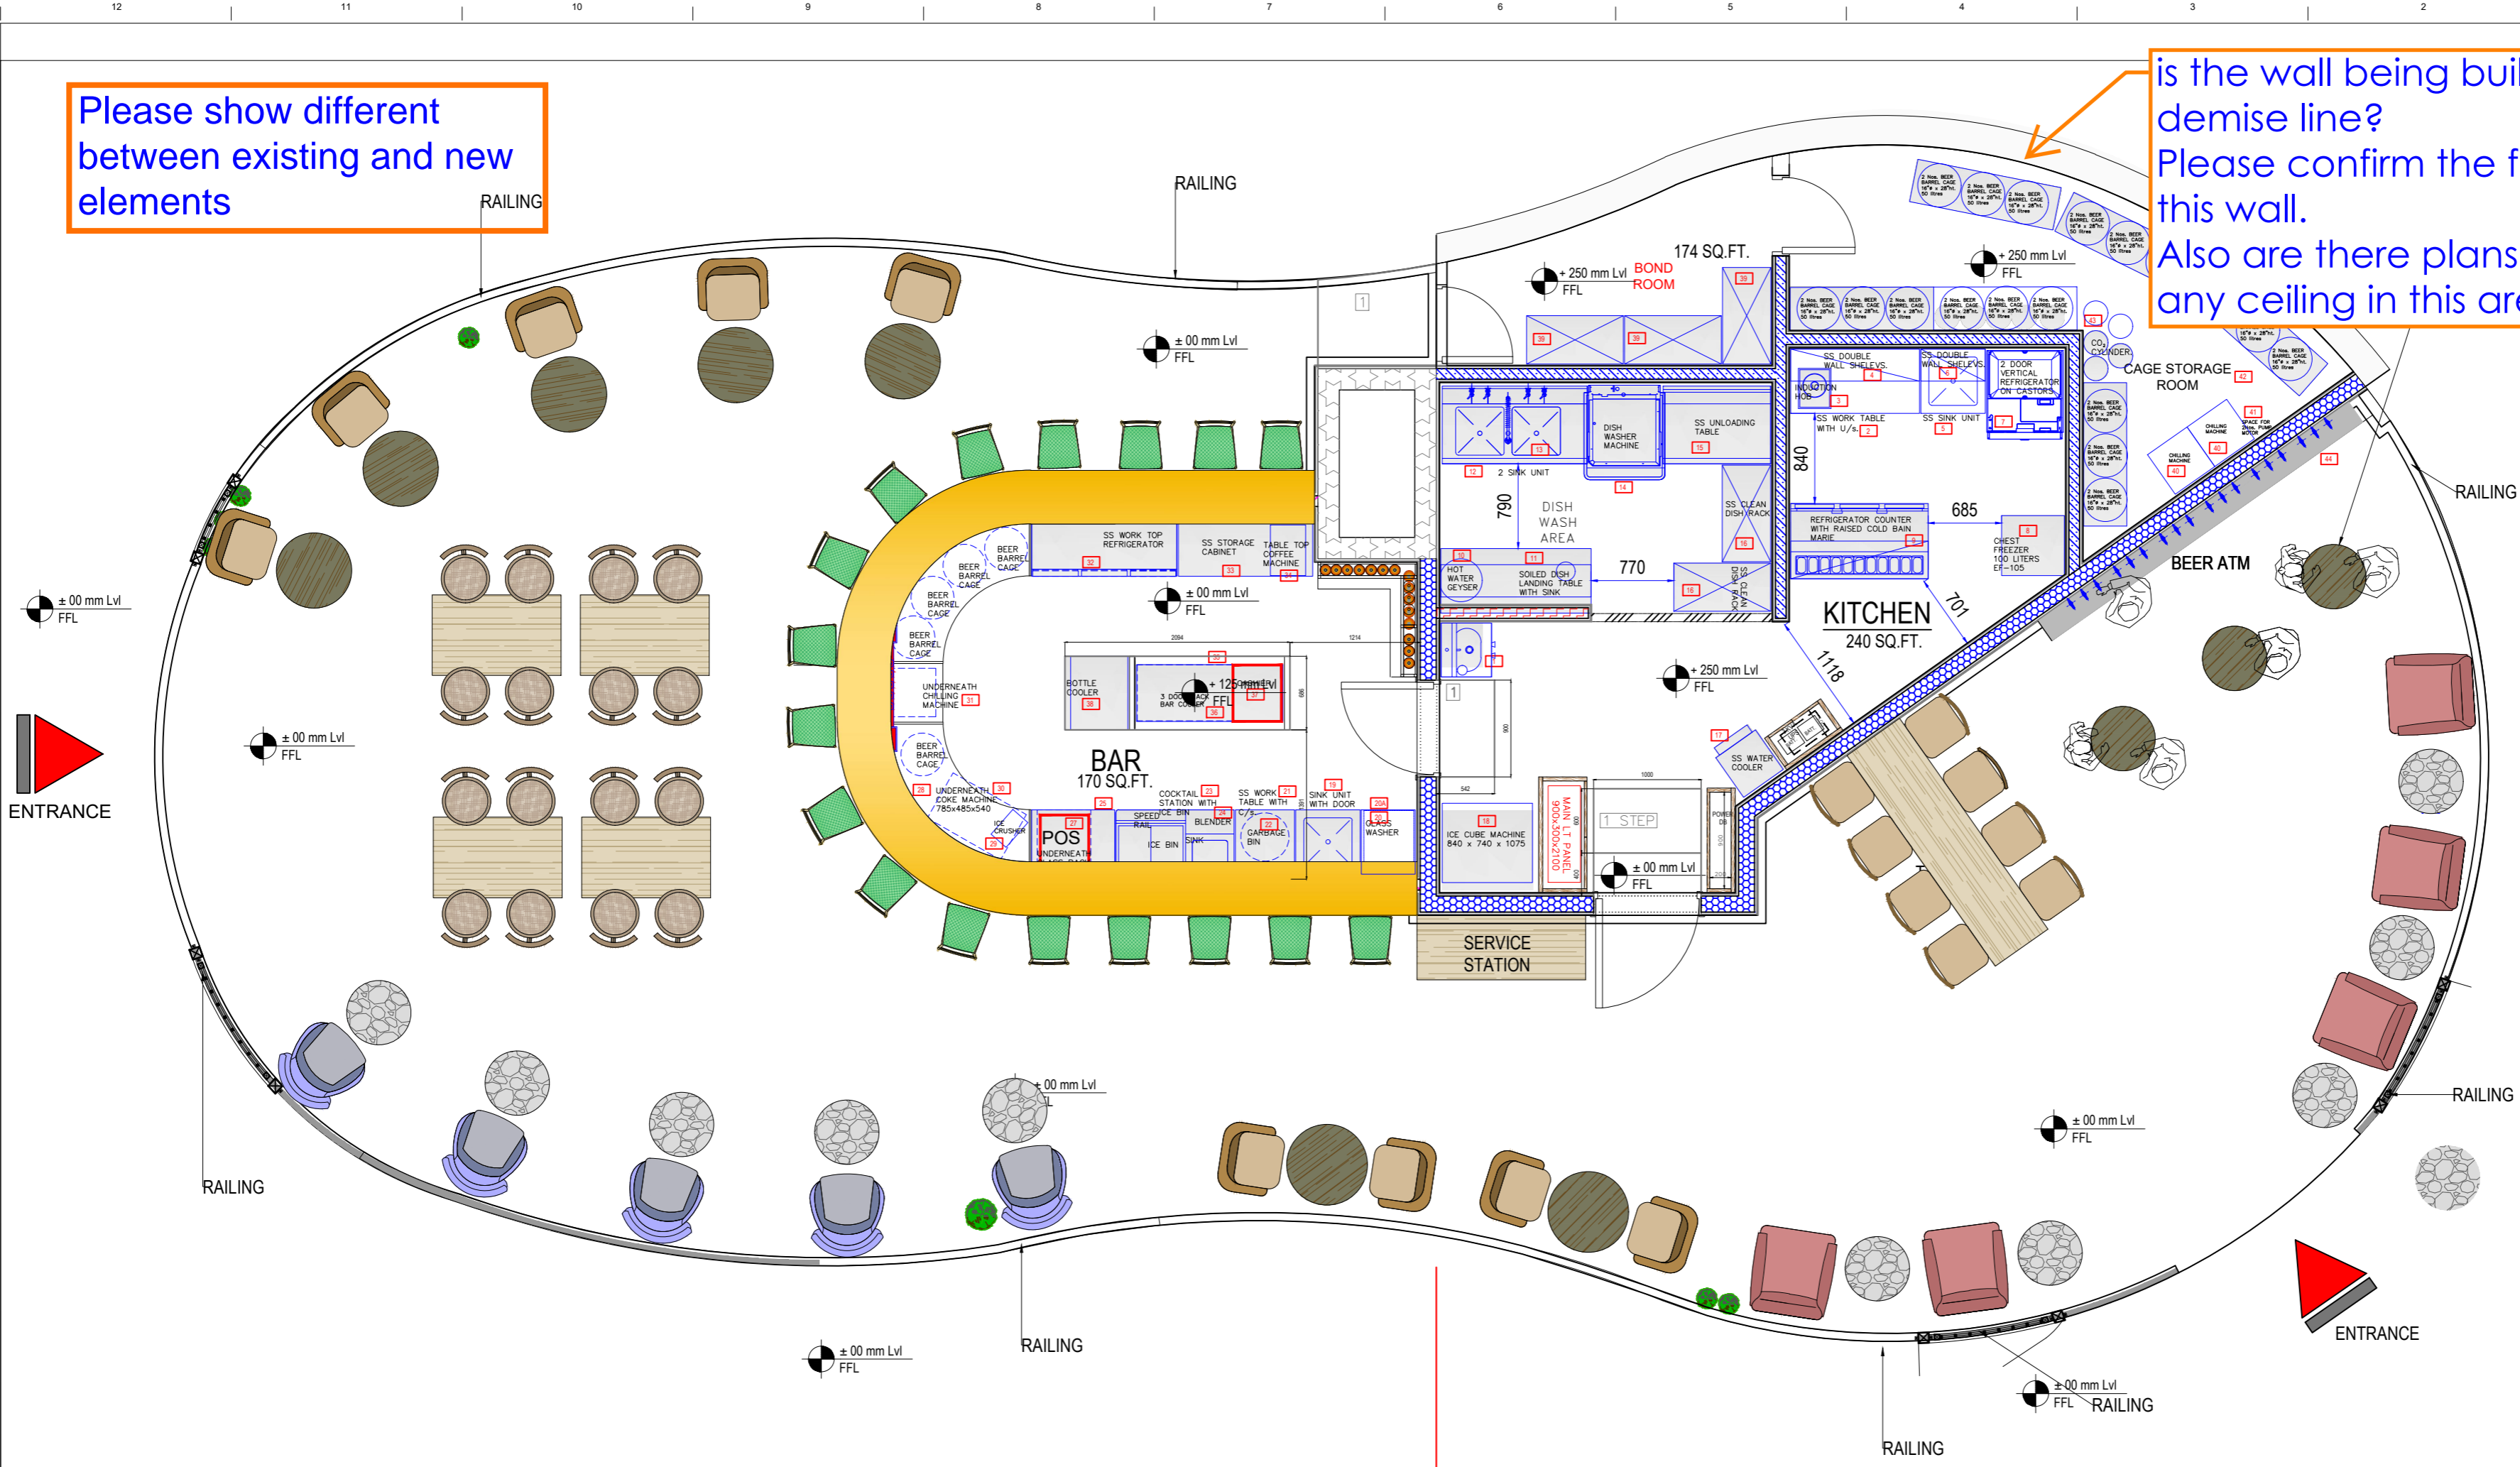

IRISH HOUSE - 179.95 SQ. MT. INTERNATIONAL SHA  
PAX -60 NOS.  
DENSITY 24.33 PER SQ.FT.

AREA QUANTITY		
SR. NO.	PARTICULARS	AREA
1	SEATING AREA	1412 SQ.FT.
2	BAR AREA	170 SQ.FT.
3	BOND & CAGE STORAGE ROOM	134 SQ.FT.
4	KITCHEN AREA	240 SQ.FT.

CURRENT	PERVIOUS
<ul style="list-style-type: none"> <li>Total Carpet area is 1956 sq. ft.</li> <li>No. of Pax 60.</li> <li>Seating area 1412 sq. ft.</li> <li>Bond &amp; Cage Room area is 134 sq. ft.</li> <li>Bar Counter_Ledge is 500MM wide. Increase the Bar Counter. add the bar stool.</li> <li>Kitchen has been revised and the area is 240 sq. ft.</li> </ul>	<ul style="list-style-type: none"> <li>Total Carpet area is 1668 sq. ft.</li> <li>No. of Pax 52.</li> <li>Seating area 929 sq. ft.</li> <li>Bond Room area is 20 sq. ft.</li> <li>Bar Counter_Ledge is 600MM wide.</li> <li>Cages Store Room area is 58 sq. ft.</li> <li>Kitchen area is 370 sq. ft.</li> </ul>

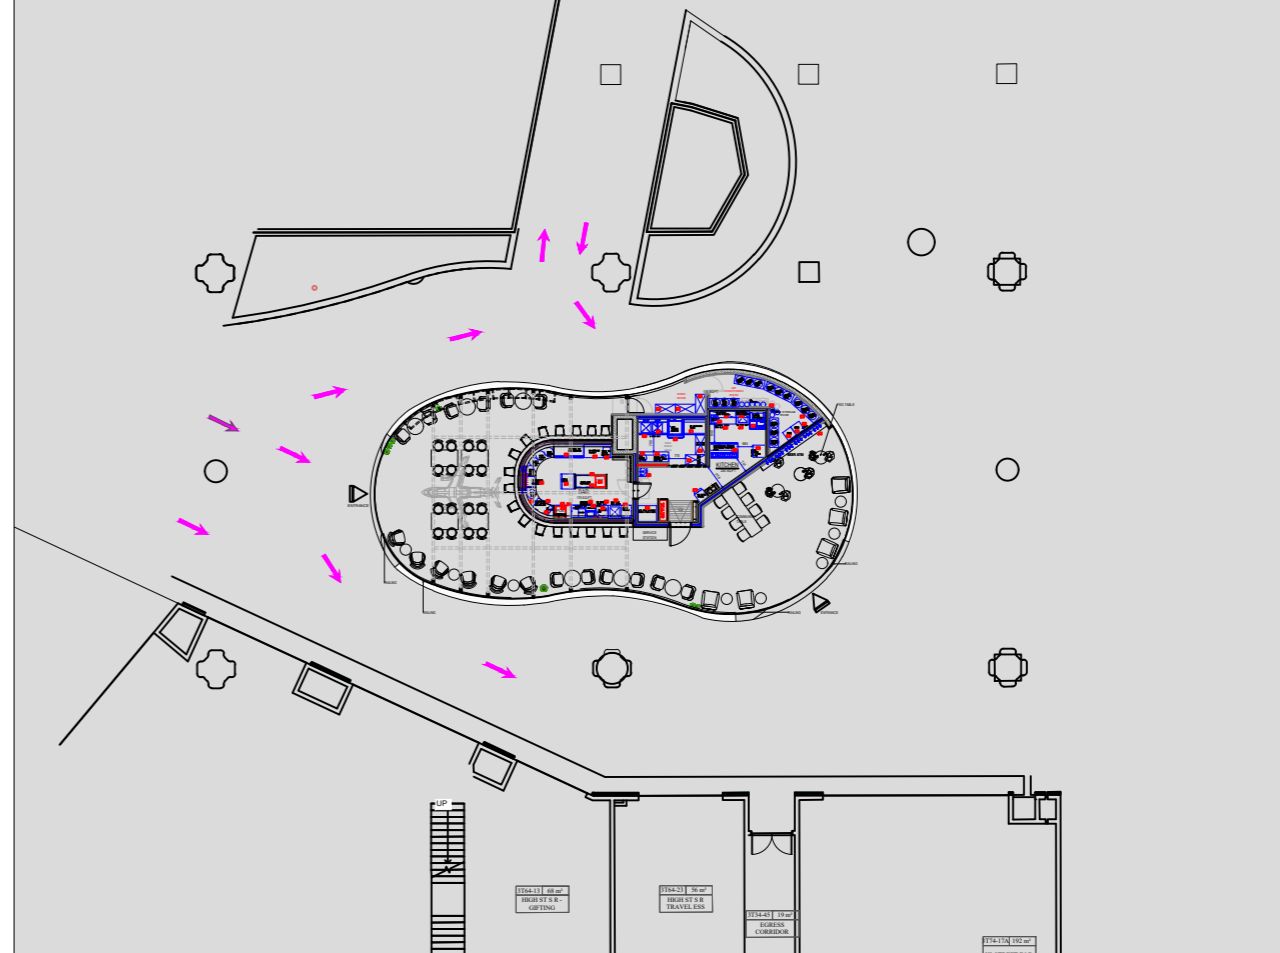

**TERMINAL 2**  
Bangalore International Airport

**Kempowada**  
Bangalore International Airport Limited  
Project Office  
Kempowada International Airport Bangalore  
Devenahalli, Bangalore 560 300 India

**SOM**  
SOM India LLC  
14 Wall Street, New York, NY 10005

**ARUP LTD.**  
77 Water Street  
New York, NY 10005


**BHP Associates**  
P.O. Box 32746  
Abu Dhabi, UAE

**Grant Associates**  
22 Milk Street  
Boston, MA 02116

**MSD**  
2 Young Place  
East Kildare, QLD 4705

**tfs**  
Travel Food Services Pvt Ltd  
14 Wall Street, New York, NY 10005

**ara**  
DESIGNS  
1st floor, 11 Regent, Malabar Hills, Chennai 600 024  
Tel : 34482334 / 34482337

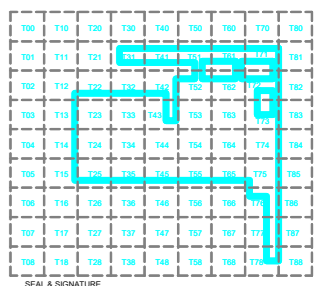

**GFC DRAWING**

CHECKED BY	DATE	CHECKED BY	DATE
ARCHITECTURE		PPND	
PROPOSED GFC CIVIL & STRUCTURE			
ELECTRICAL		PHE	
MECHANICAL			
PLUMBING			
MECHANICAL			

**Revision Schedule**


Revision Number	Revision Description	Revision Date	Issued by	Issued to
1	Layout revision	08.21.2021	AD	TFS
2	Layout revision	03.08.2023	AD	TFS
3	Kitchen Layout revision	03.09.2023	AD	TFS
4	Kitchen Layout revision	03.10.2023	AD	TFS
5	Kitchen area reduced	03.16.2023	AD	TFS
6	Upgraded seating area	03.17.2023	AD	TFS
7	Civil Changes (remove Ramp & add Stairs)	06.20.2023	AD	TFS
8	Revised Layout	06.28.2023	AD	TFS
9	Revised Layout	08.27.2024	AD	TFS

DESIGN BY	DRAWN BY	CHECKED BY	APPROVED BY
ARA	ARA	ARA	ARA

**PROPOSED LAYOUT OF IRISH HOUSE INT.T2 BIAL**  
179.95 SQMTRS (3T63 -29)

**KIA-B03-TFS-A\_MC-L3-DWG-1001**  
SCALE: 1:50  
SHEET SIZE: A2



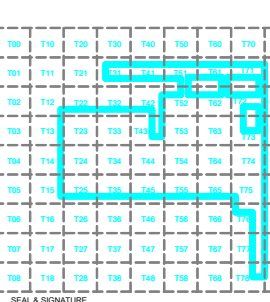

**GFC DRAWING**

NO.	DESCRIPTION	DATE	BY	CHECKED BY
1	PROPOSED GFC CHIL & STRUCTURE	PPND		
2	ELECTRICAL	ME		
3	ELV SYSTEM	LAPORRY SYSTEM		
4	MEP	MEP		
5	REVISIONS			

Revision Schedule					
Revision Number	Revision Description	Revision Date	Issued by	Issued to	Issued by
1	Layout revision	03.08.2023	AD	TFS	
2	Kitchen Layout revision	03.09.2023	AD	TFS	
3	Kitchen Layout revision	03.10.2023	AD	TFS	
4	Kitchen area reduced	03.16.2023	AD	TFS	
5	Updated seating area	03.17.2023	AD	TFS	
6	revised the elevation	06.28.2023	AD	TFS	
7	Chil Changes (remove Ramp & add Stairs)	06.30.2023	AD	TFS	
8	Revised Layout	06.28.2023	AD	TFS	
9	Revised Layout	08.27.2024	AD	TFS	

DESIGN BY	DRAWN BY	CHECKED BY	APPROVED BY
RAJAN	ALTAJ	RAJAN	AJRA DEJNE

GRIDLINE

DRAWING TITLE

ELEVATION BB OF IRISH HOUSE INT. T2 BIAL 179.95 SQMTRS (3T63 -29)


DRAWING NUMBER

KIA-B03-TFS-A\_MC-L3-DWG-1017


SCALE: 1:50


SHEET SIZE: A2

SHEET NO: 18

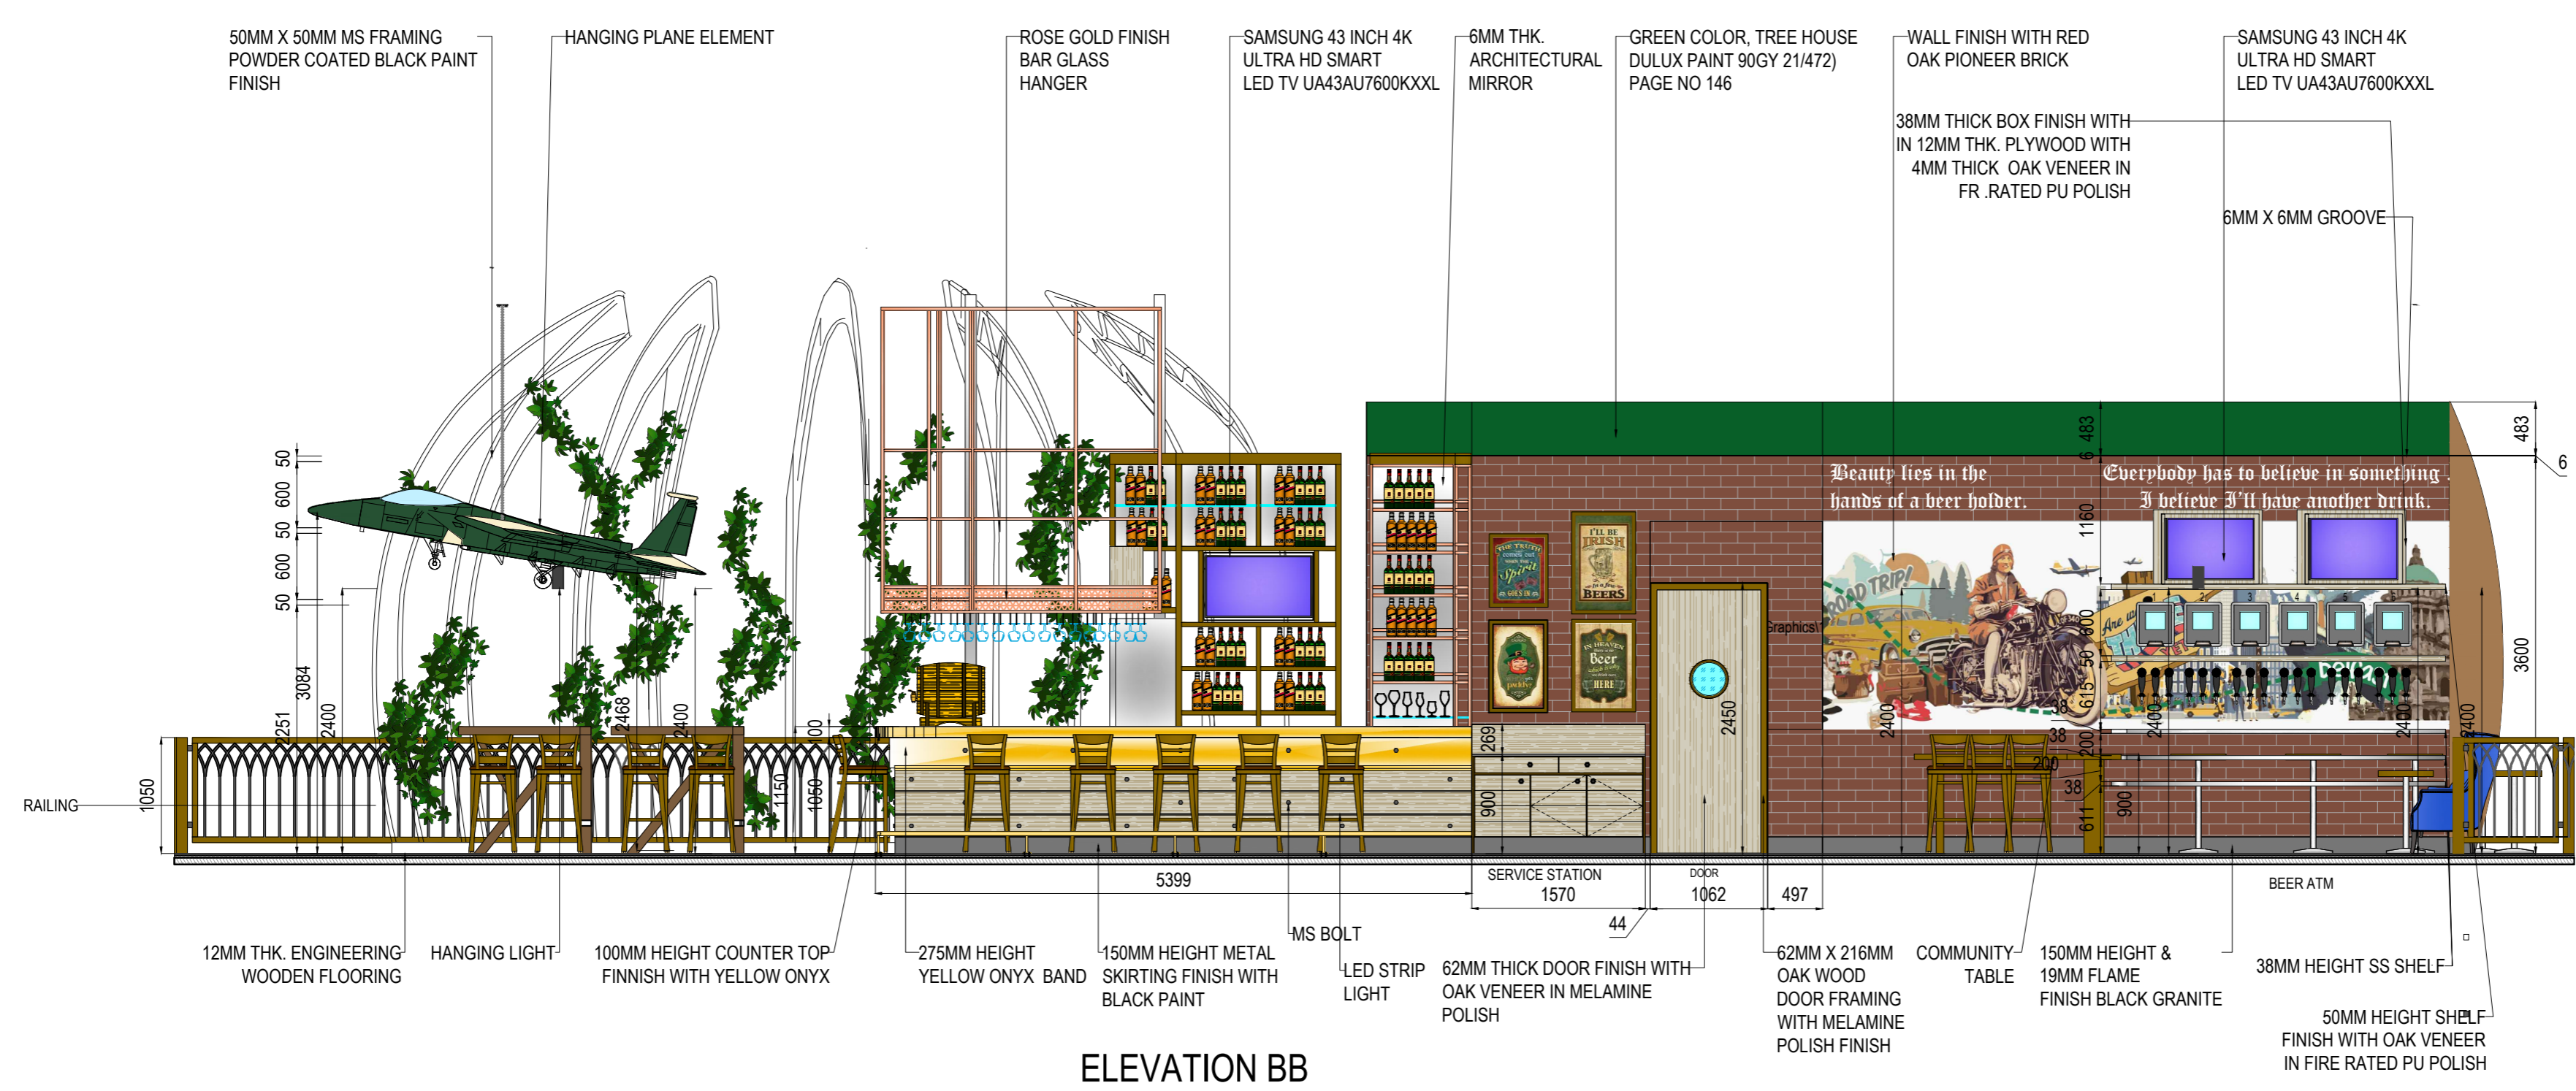

**ELEVATION BB**

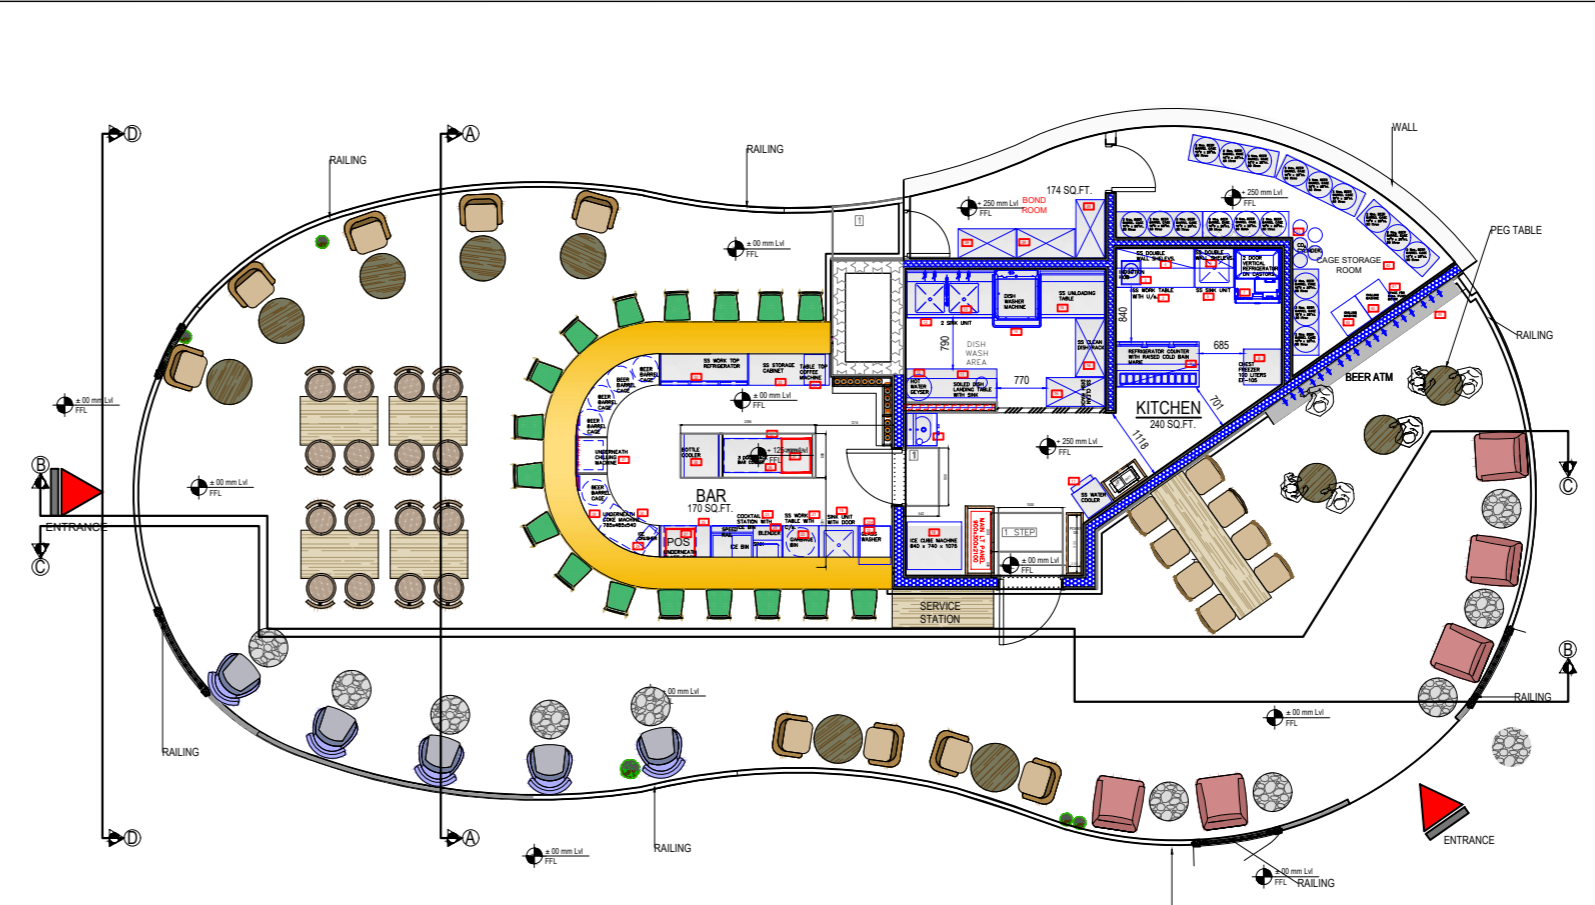

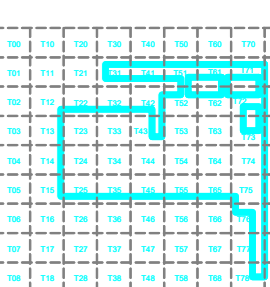

**GFC DRAWING**


NO.	DATE	BY	CHECKED BY	DESCRIPTION
1	03.08.2023	AD	TFS	PROPOSED GFC CHIL & STRUCTURE
2	03.09.2023	AD	TFS	ELECTRICAL
3	03.10.2023	AD	TFS	ELV SYSTEM
4	03.16.2023	AD	TFS	MEP SYSTEM
5	03.17.2023	AD	TFS	MEP SYSTEM

Revision Number	Revision Description	Revision Date	Issued by	Issued to
1	Layout revision	03.08.2023	AD	TFS
2	Kitchen Layout revision	03.09.2023	AD	TFS
3	Kitchen Layout revision	03.10.2023	AD	TFS
4	Kitchen area reduced	03.16.2023	AD	TFS
5	Updated seating area	03.17.2023	AD	TFS
6	revised the elevation	06.28.2023	AD	TFS
7	Chil Changes (remove Ramp & add Stairs)	06.30.2023	AD	TFS
8	Revised Layout	06.28.2023	AD	TFS
9	Revised Layout	08.27.2024	AD	TFS

DESIGN BY	DRAWN BY	CHECKED BY	APPROVED BY
RAJAN	ALTAJ	RAJAN	AJRA DEJNE

**ELEVATION CC OF IRISH HOUSE INT.T2 BIAL**  
179.95 SQMTRS (3T63 -29)

**KIA-B03-TFS-A\_MC-L3-DWG-1018**  
SCALE: 1:50  
SHEET SIZE: A2  
SHEET NO: 19

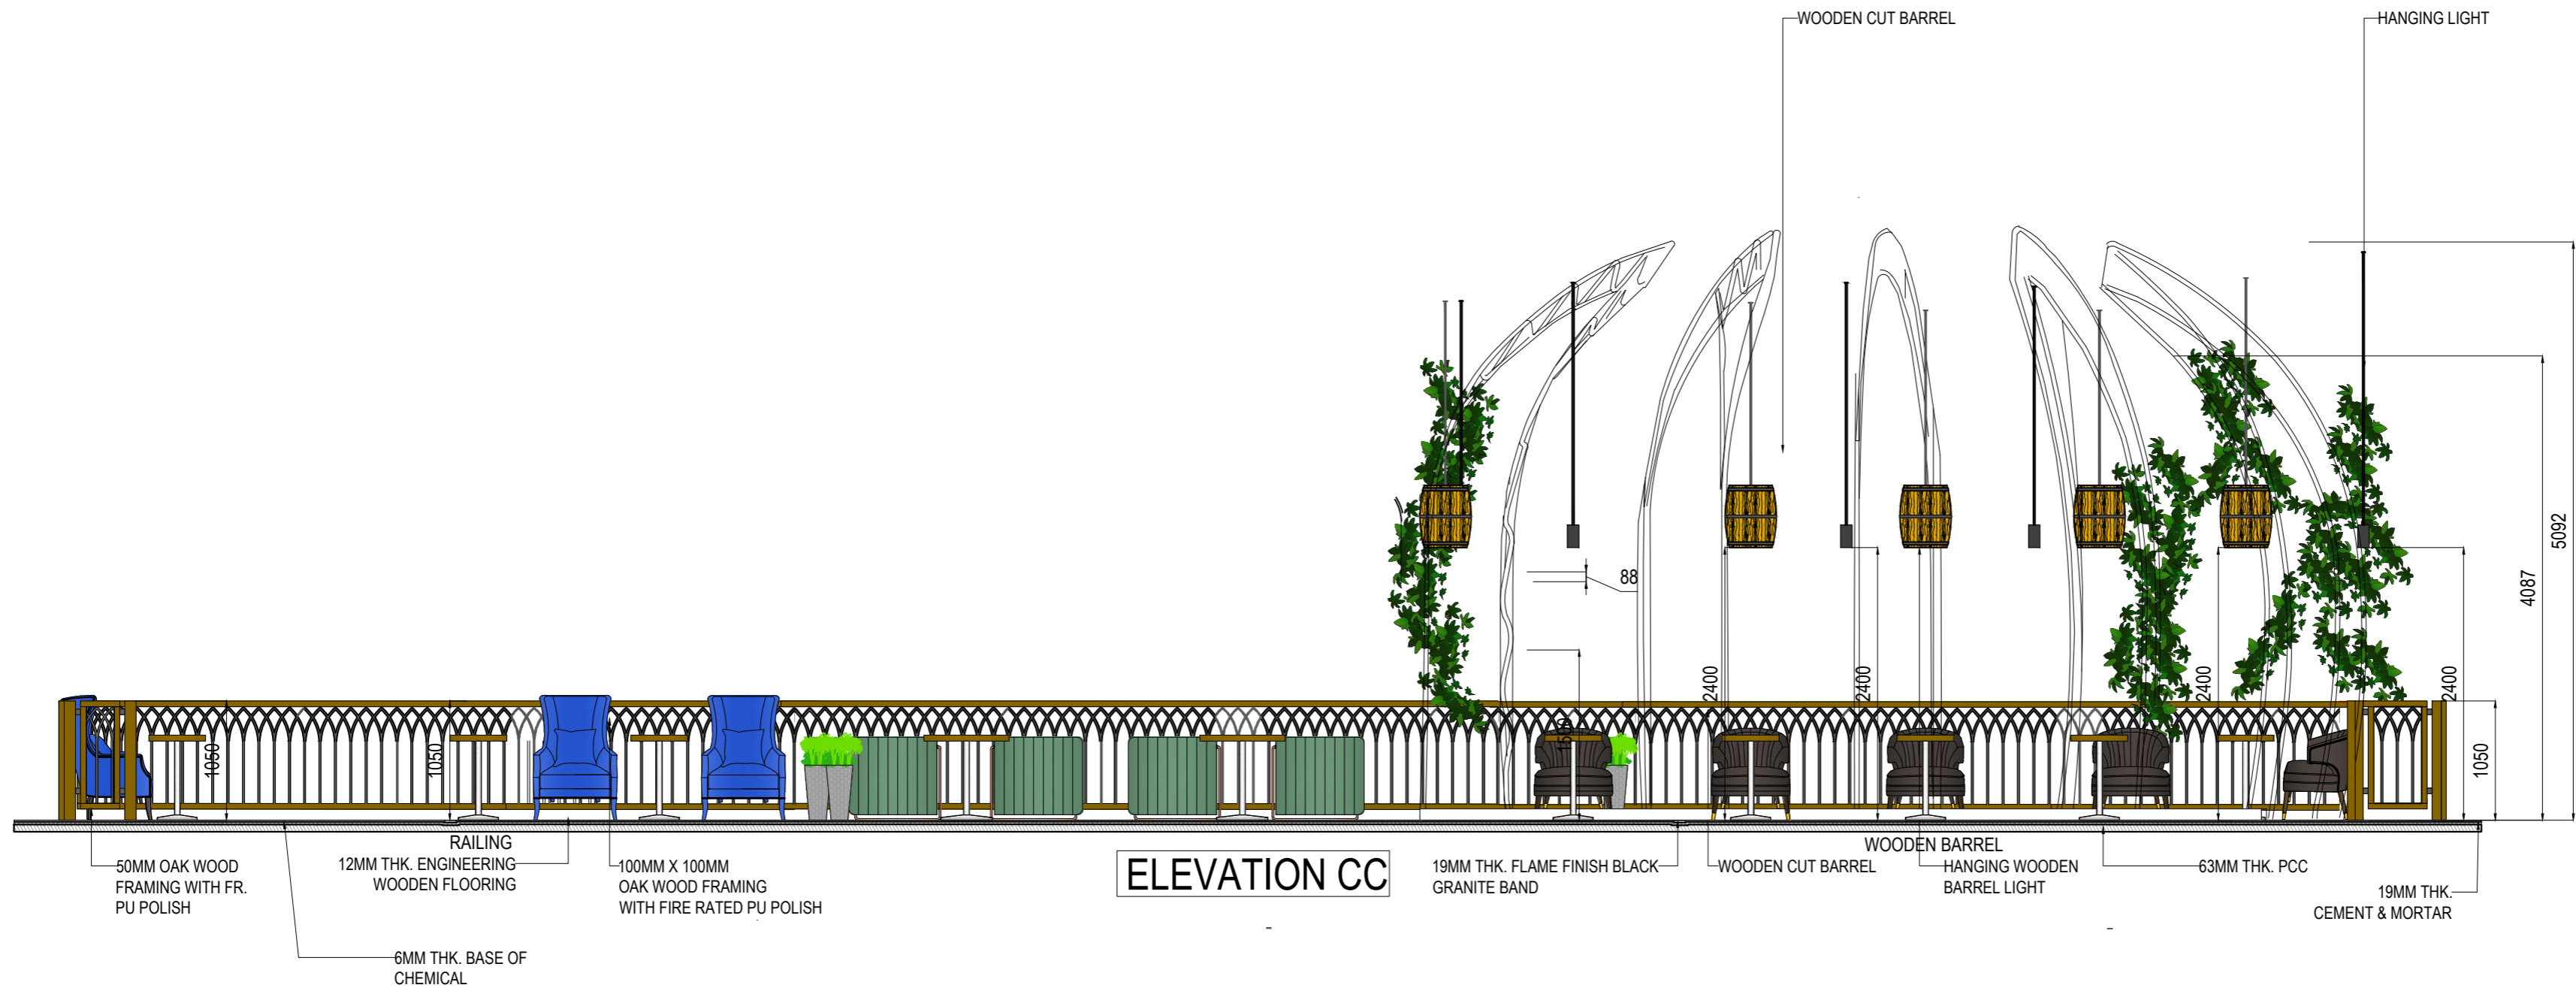

**ELEVATION CC**

- 50MM OAK WOOD FRAMING WITH FR. PU POLISH
- RAILING
- 12MM THK. ENGINEERING WOODEN FLOORING
- 100MM X 100MM OAK WOOD FRAMING WITH FIRE RATED PU POLISH
- 6MM THK. BASE OF CHEMICAL
- 19MM THK. FLAME FINISH BLACK GRANITE BAND
- WOODEN CUT BARREL
- WOODEN CUT BARREL
- HANGING WOODEN BARREL LIGHT
- 63MM THK. PCC
- 19MM THK. CEMENT & MORTAR

